


Jackson Terminal Common Area Total Sq. Ft.	Suite	Net Leasable Sq. Ft.	Proportion of Common Area Sq. Ft.	Total Rentable Sq. Ft.	Unit share of common area
3049					
	213	7818	1484	9302	48.7%
	211	1913	363	2276	11.9%
	209	1010	192	1202	6.3%
	207	1372	260	1632	8.5%
	205	3948	749	4697	24.6%

Common Area

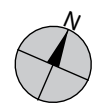

**Jackson Terminal**

865-523-9867  
 203 W Jackson Ave, Knoxville, TN 37902  
[www.jackson-terminal.com](http://www.jackson-terminal.com)